Thursday, 05/02/2009 9:19:47 AM

User:

Julie Dawson

## **Process Sheet**

Customer

: CU-DAR001 Dart Helicopters Services

S.O. No. :

Job Number : 45503

**Estimate Number** 

: 13652

P.O. Number This Issue

Prsht Rev.

First Issue

: 05/02/2009

: NC

: //

: 45227

: LARGE FAB ASSY Type

**Part Number** 

**Drawing Name** 

: D22351 · D2235 REV B1

: BASKET RIBS

**Drawing Number** Project Number

: N/A

**Drawing Revision** 

: B1

Material

: 12/02/2009 **Due Date** 

Qty:

4 Um:

Each

**Previous Run** Written By

Checked & Approved By

Comment

: Est Rev:A

New Issue 08-12-01 DD verified by:EC

**Additional Product** 

Job Number:



Seq. #:

**Machine Or Operation:** 

Description:

1.0

D31661

Basket Hoop

Comment: Qty.:

1.0000 Each(s)/Unit

Total:

4.0000 Each(s)

Basket Hoop

Batch:

B44996

2.0

LARGE FABRICATION RESOURCE







Comment: LARGE FABRICATION RESOURCE 1

- 1- Pick D3166-1 and cut as per dwg D2235 using DT8302
- 2- remove identification markings on tube
- 3- deburr

INSPECT WORK TO CURRENT STEP



3.0

QC5



Comment: INSPECT WORK TO CURRENT STEP

PACKAGING 1

PACKAGING RESOURCE #1



4.0



Comment: PACKAGING RESOURCE #1

Identify and Stock Location: WA

5.0

QC21

FINAL INSPECTION/W/O RELEASE



Comment: FINAL INSPECTION/W/O RELEASE

Job Completion




## **Dart Aerospace Ltd**

W/O:		WORK ORDER O	CHANGES								
DATE	STEP	PROCEDURE CHANGE	Ву	Date	Qty	Approval Chief Eng / Prod Mgr	Approval QC Inspector				
		•									
							:				
<del>-</del>											

Part No:		PAR #:	Fault Category:	NCR: Yes No I	DQA:	Date:	
	Resolution:		Disposition:	QA: N/C Closed:		Date:	

NCR:			WORK ORD	ER NON-CONFORMAN	CE (NCR)					
		Description of NC		Corrective Action Section B						
DATE	STEP	Section A	Initial Chief Eng	Action Description Chief Eng	Sign & Date	Verification Section C	Approval Chief Eng	Approval QC Inspector		
				•						
<del></del>										

NOTE: Date & initial all entries

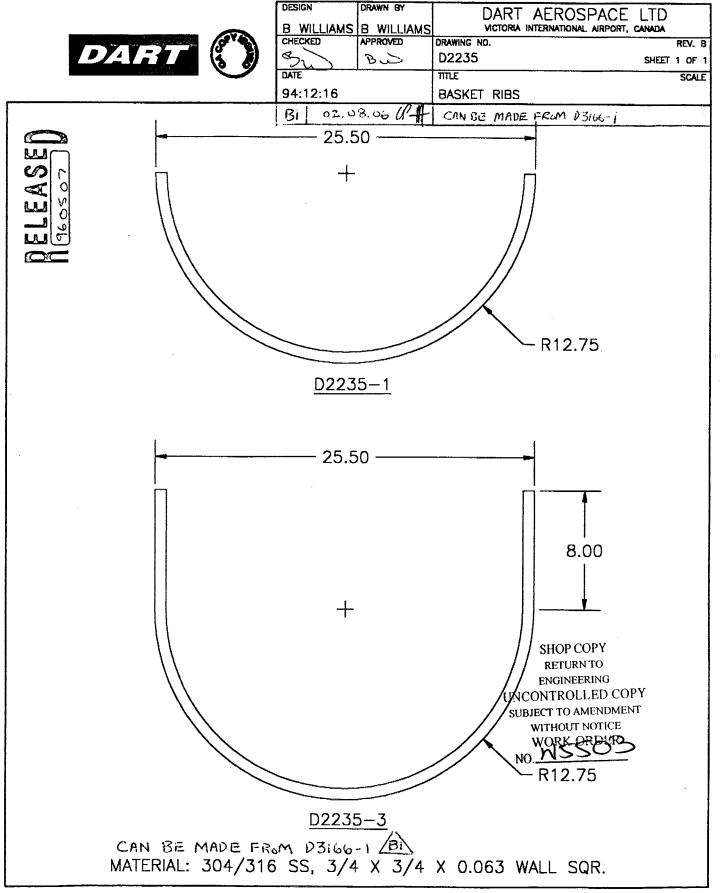

## **Dart Aerospace Ltd**

W/O:		WORK ORDER CHANGES							
DATE	STEP	PROCEDURE CHANGE By Date	Date	Qty	Approval Chief Eng / Prod Mgr	Approval QC Inspector			
		•							

Part No:		PAR #:	Fault Category:	NCR: Yes No DQA:	Date:
	Resolution:		Disposition:	QA: N/C Closed:	Date:

NCR:			WORK ORDE	ER NON-CONFORMAN	CE (NCR)						
		Description of NC	Corrective Action Section B			Verification	A				
DATE	STEP	Section A	Initial Chief Eng	Action Description Chief Eng	Sign & Date	Section C	Approval Chief Eng	Approval QC Inspector			
			·								

NOTE: Date & initial all entries